

Date: Friday, 5/25/2007 8:16:47 AM
 User: Kim Johnston

Process Sheet

Customer	: CU-DAR001 Dart Helicopters Services	Drawing Name	: FORWARD CAP - UNDER REVIEW
Job Number	: 32584		
Estimate Number	: 10501		
P.O. Number	: N/A	Part Number	: D2744
This Issue	: 5/25/2007	S.O. No.	: N/A
Prsht Rev.	: NC	Drawing Number	: D2744 UNDER REVIEW
First Issue	: N/A	Project Number	: N/A
Previous Run	: 29784	Drawing Revision	: B1
		Material	: N/A
		Due Date	: 6/30/2007
Written By	: <u>07.05.28</u>	Qty:	30 Um: Each
Checked & Approved By	: <u>07.05.28</u>		
Comment	: Est C 03.01.17 Reformat; Dwg revised KJ/RF Est Rev:D Now on Waterjet 06-06-16 JLM		

Additional Product

Job Number:



Seq. #:	Machine Or Operation:	Description:
---------	-----------------------	--------------

1.0	M5052H32S080	5052-H32 .080 Sheet
-----	--------------	---------------------



Comment: Qty.: 0.1914 sf(s)/Unit Total: 5.7425 sf(s)
 Material: 5052-H32 (QQ-A-250/8) or 6061-T6 (QQ-A-250/11) 0.080 thick.
 Use off-cuts
 M5052H32S.080) Batch m104392X⁴⁻⁶⁰⁶¹ ml 07 06 10 (30)

2.0	WATER JET	FLOW WATER JET
-----	-----------	----------------



Comment: FLOW WATER JET
 1-Cut as per Dwg D2744
 Dwg Rev: B1 ml 07 06 10 (30)
 Prog Rev: B1

2-Deburr if necessary mf 07-06-25 (30)

3.0	QC2	INSPECT PARTS AS THEY COME OFF MACHINE
-----	-----	--



ml 07 06 10 (30)



Comment: INSPECT PARTS AS THEY COME OFF MACHINE

4.0	QC8	SECOND CHECK
-----	-----	--------------



07.06.11 (30)



Comment: SECOND CHECK

5.0	PACKAGING 1	PACKAGING RESOURCE #1
-----	-------------	-----------------------



Comment: PACKAGING RESOURCE #1

Identify and Stock
 Location: BARCLAY

07/06/26 (30)

W/O:		WORK ORDER CHANGES					
DATE	STEP	PROCEDURE CHANGE	By	Date	Qty	Approval Chief Eng / Prod Mgr	Approval QC Inspector

Part No: _____ PAR #: _____ Fault Category: _____ NCR: Yes ☒ No ☐ DQA: ☒ Date: 07/04/26
 QA: N/C Closed: _____ Date: _____

NCR:		WORK ORDER NON-CONFORMANCE (NCR)						
DATE	STEP	Description of NC Section A	Corrective Action Section B			Verification Section C	Approval Chief Eng	Approval QC Inspector
			Initial Chief Eng	Action Description Chief Eng	Sign & Date			

NOTE: Date & initial all entries

Date: Friday, 5/25/2007 8:16:47 AM
User: Kim Johnston

Process Sheet

Customer: CU-DAR001 Dart Helicopters Services

Drawing Name: FORWARD CAP - UNDER REVIEW

Job Number: 32584

Part Number: D2744

Job Number:



Seq. #:

Machine Or Operation:

Description :

6.0

QC21

FINAL INSPECTION/W/O RELEASE



(30)

Comment: FINAL INSPECTION/W/O RELEASE

2010/06/26

Job Completion



U 87-0626


 
 
 

W/O:		WORK ORDER CHANGES					
DATE	STEP	PROCEDURE CHANGE	By	Date	Qty	Approval Chief Eng / Prod Mgr	Approval QC Inspector

Part No: _____ PAR #: _____ Fault Category: _____ NCR: Yes No DQA: _____ Date: _____

QA: N/C Closed: _____ Date: _____

NCR:		WORK ORDER NON-CONFORMANCE (NCR)						
DATE	STEP	Description of NC Section A	Corrective Action Section B			Verification Section C	Approval Chief Eng	Approval QC Inspector
			Initial Chief Eng	Action Description Chief Eng	Sign & Date			

NOTE: Date & initial all entries

DESIGN 	DRAWN BY 	DART AEROSPACE USA, INC. PORT HADLOCK, WA	
CHECKED 	APPROVED 	DRAWING NO. D2744	REV. B SHEET 1 OF 1
DATE 02.12.18		TITLE CAP	SCALE 1:1
A	98.04.16	NEW ISSUE	
B	02.12.18	REDESIGN	
Bi	 04.03.10	6.52 WAS 6.27 ; 3.26 WAS 3.13	

RELEASED
02.12.18

~~UNDER REVIEW~~


04.03.02 TT

OK 04.03.10

~~UNDER REVIEW~~

~~06.06.28 CB~~

~~update drug
OK to mfg~~

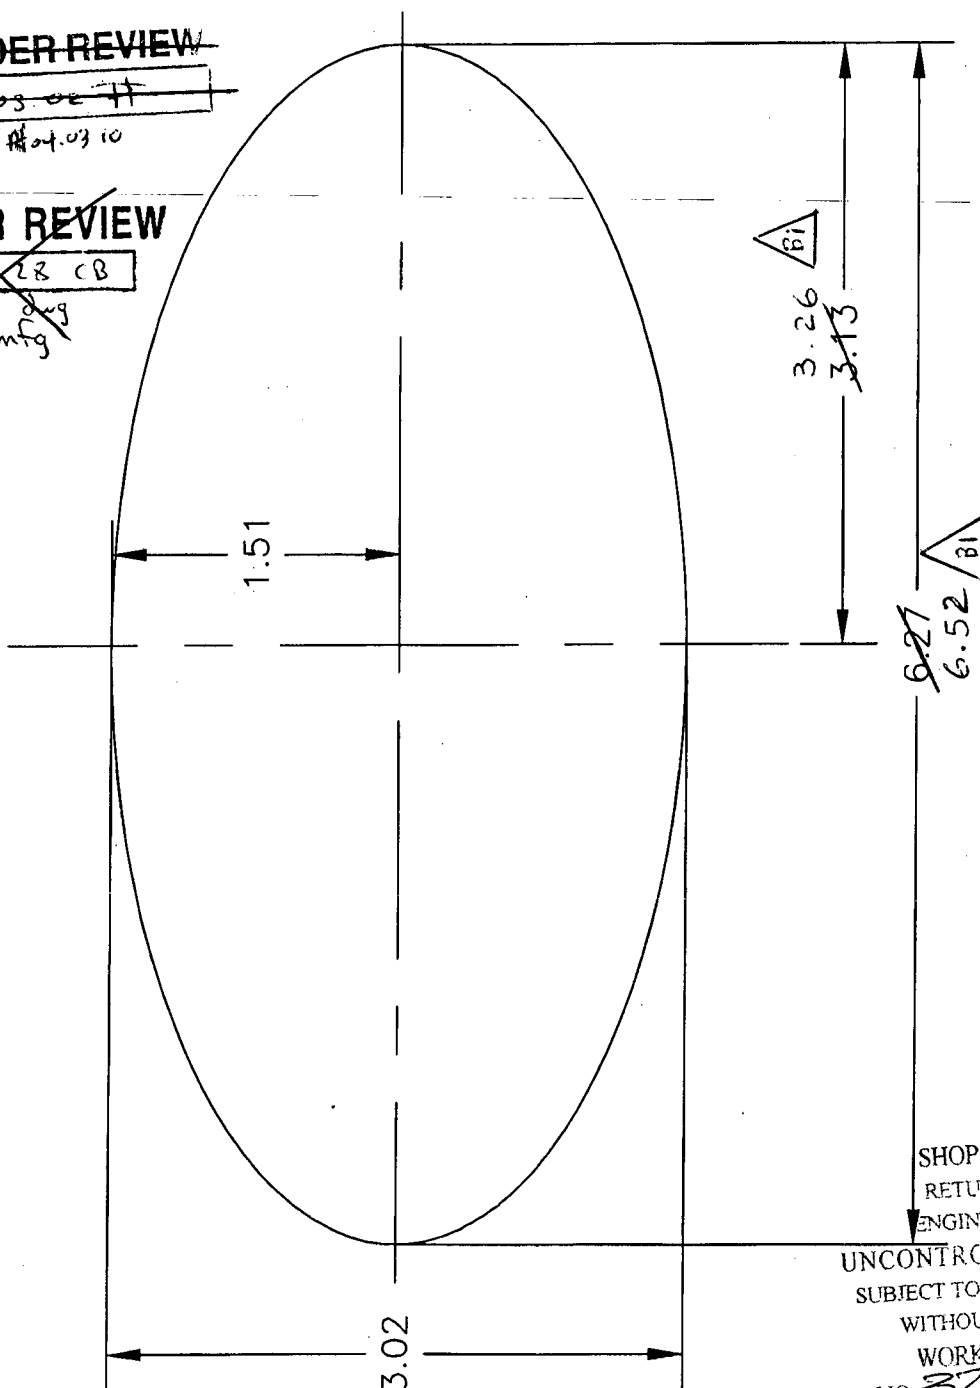

SHOP COPY
RETURN TO
ENGINEERING

UNCONTROLLED COPY
SUBJECT TO AMENDMENT
WITHOUT NOTICE
WORK ORDER
NO. 32584

NOTES

- NOTES:
- 1) MATERIAL: 6061-T6 (QQ-A-250/11) OR 5052-H32 (QQ-A-250/8), 0.080 THICK (REF. DART SPEC M6061T6S.080 OR M5052H32S.080)
 - 2) FINISH: NONE
 - 3) TOLERANCES ARE PER DART QSI 018 UNLESS OTHERWISE NOTED
 - 4) ALL DIMENSIONS ARE IN INCHES

Copyright © 1998 by DART AEROSPACE USA, INC.

THIS DOCUMENT IS PRIVATE AND CONFIDENTIAL AND IS SUPPLIED ON THE EXPRESS CONDITION THAT IT IS NOT TO BE USED FOR ANY PURPOSE OR COPIED OR COMMUNICATED TO ANY OTHER PERSON WITHOUT WRITTEN PERMISSION FROM DART AEROSPACE USA, INC.